


**PLAN**  
SCALE: 1" = 50'  
1 FT CONTOUR INTERVAL

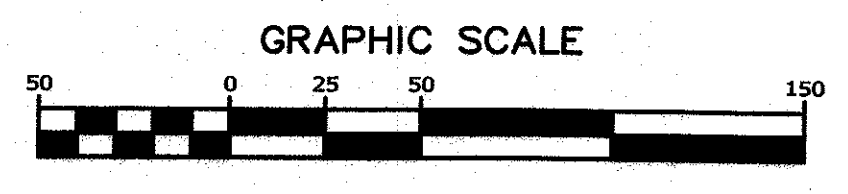

Seal	Date
	8/29/2017

No.	Revisions	Date
1	RECORD DRAWINGS	8/29/2017
2		
3		
4		
5		
6		

**THE EADS GROUP**  
ENGINEERING ARCHITECTURE AND DESIGN SERVICES

450 ABERDEEN DRIVE  
SOMERSET, PA, 15501  
Phone: 814-445-6351  
Fax: 814-443-2748  
www.eadsgroup.com

Checked By: P.J.W./B.R.S.  
Project No.: 0320-12-100  
File No.: S-PR-03(P)AN

**STONYCREEK TOWNSHIP**  
**LAKE STONYCREEK SEWER PROJECT**  
**CONTRACT NO. 12-S-03 SEWERLINES**  
**SANITARY SEWER PLAN and**  
**EROSION & SEDIMENTATION CONTROL PLAN**

Drawing No.  
**30**